


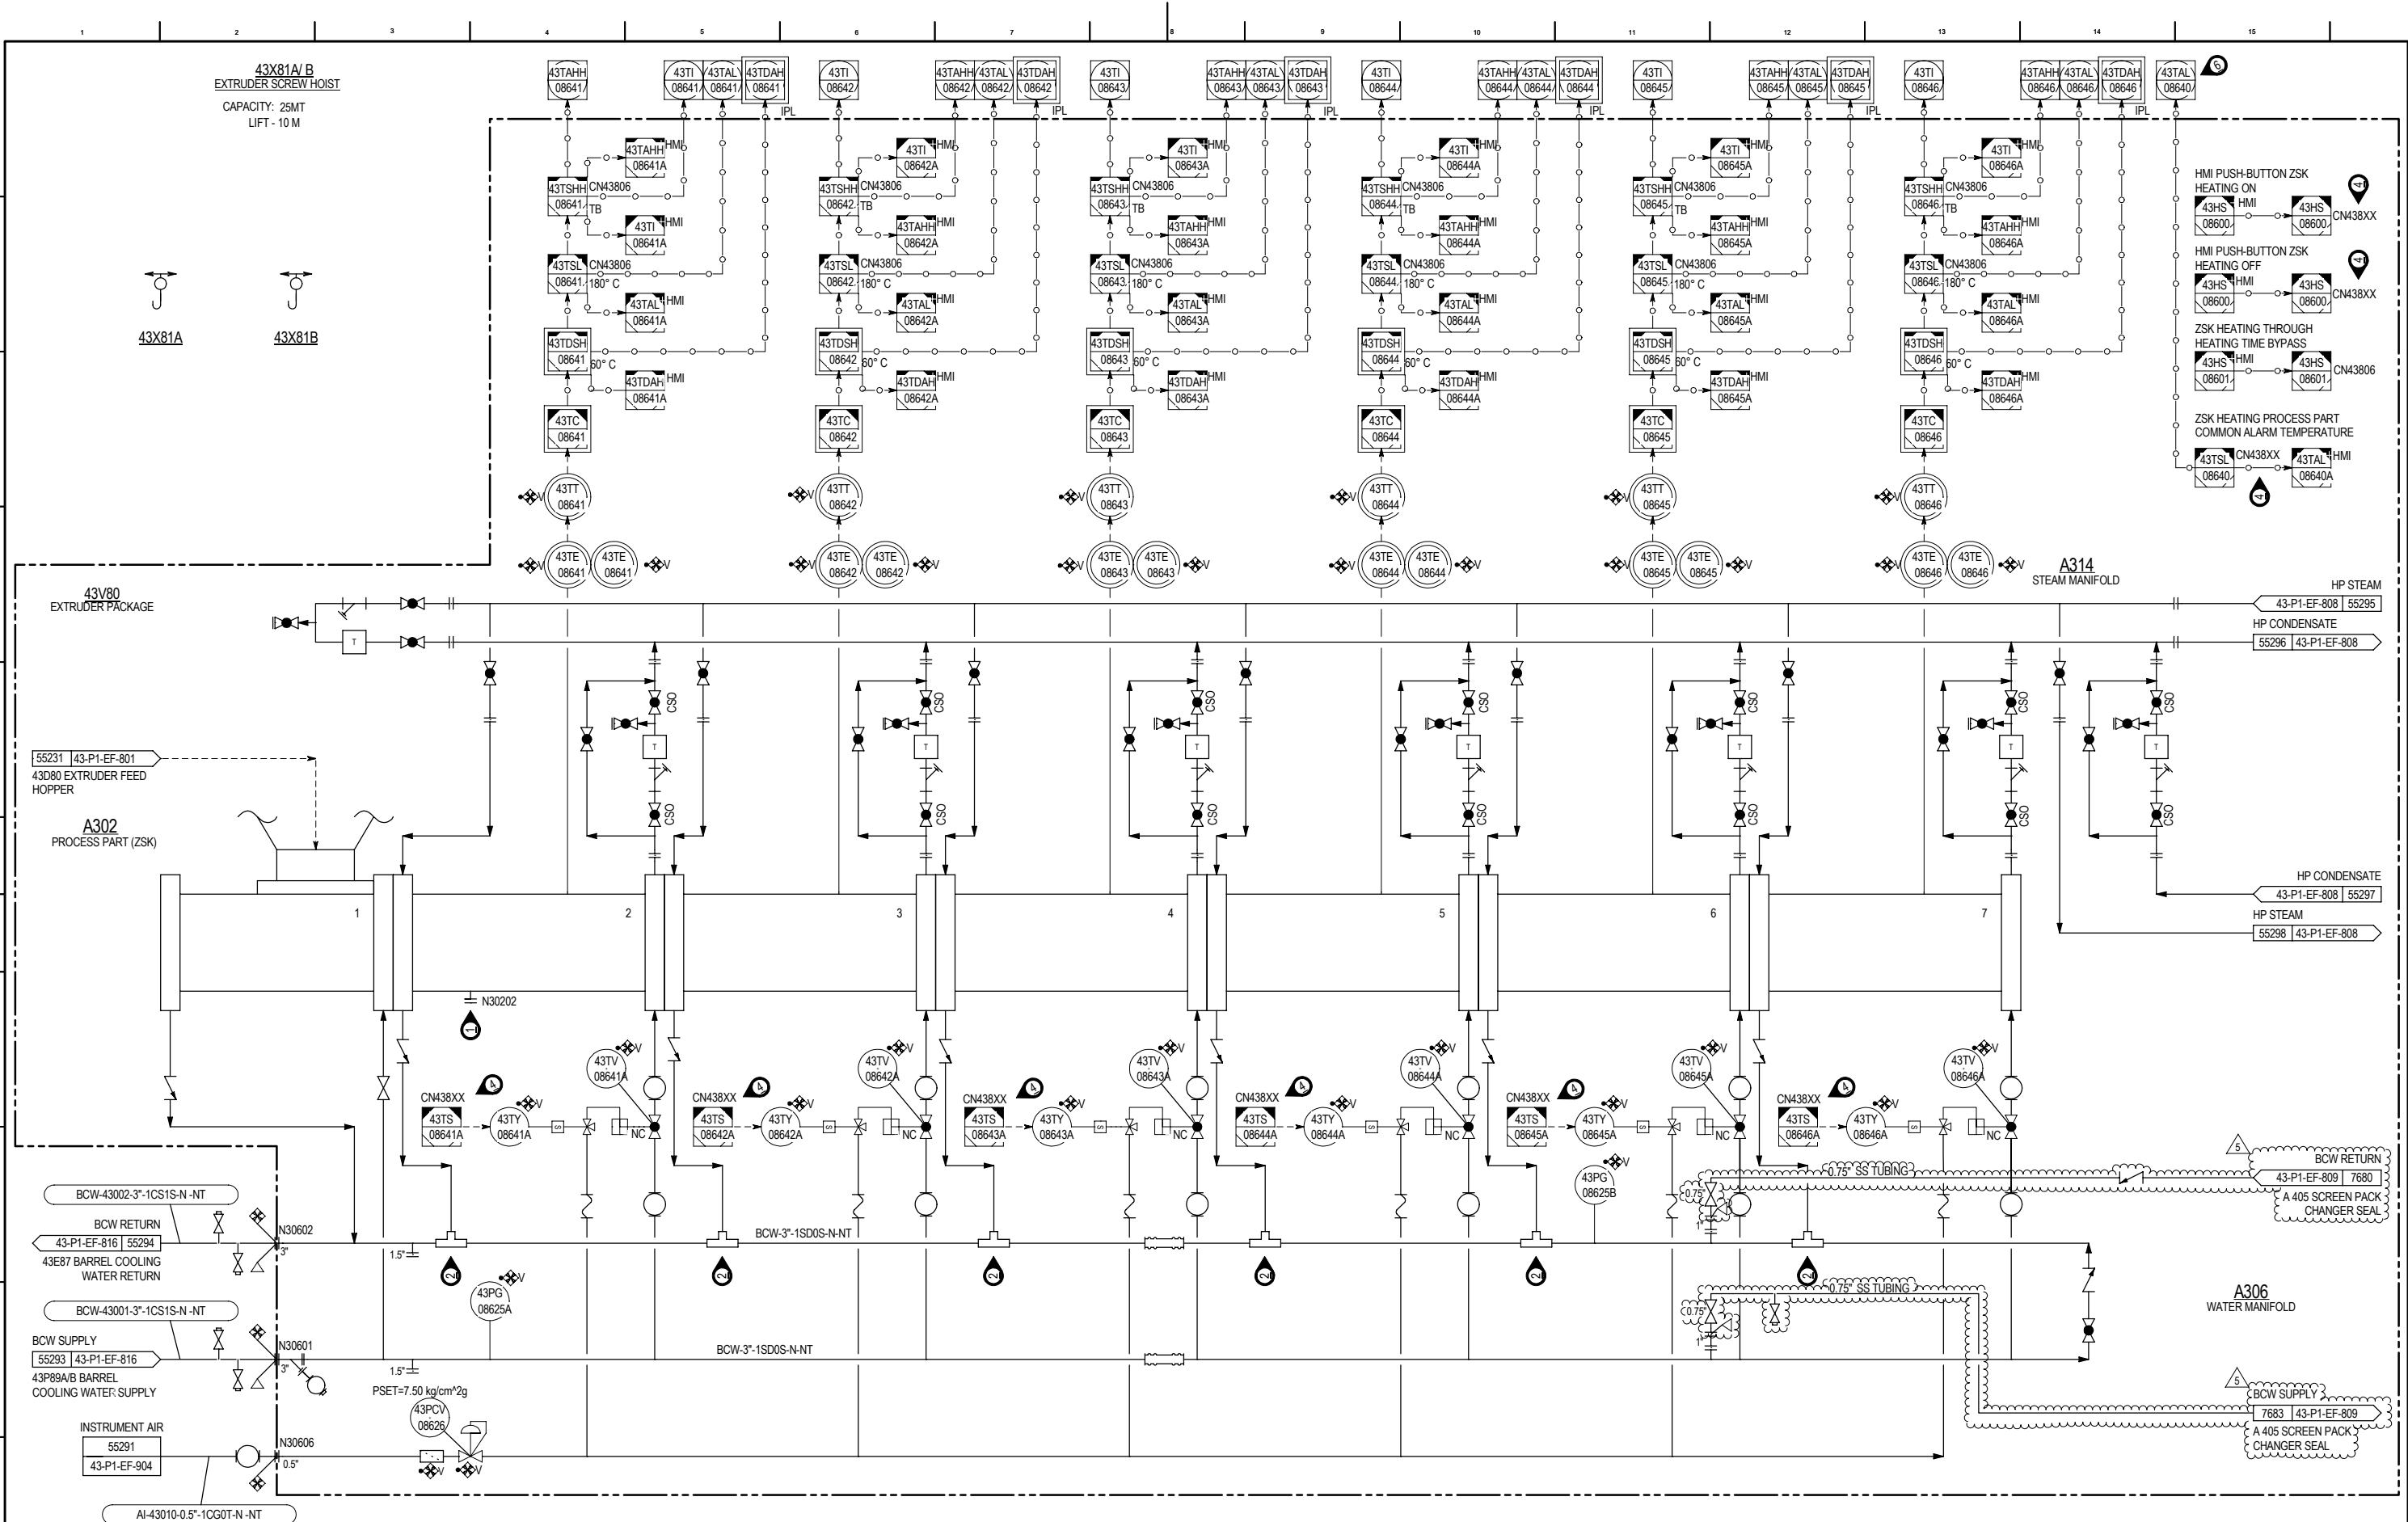

NOTES

1. PLUG FOR INJECTION NOZZLE.

2. STEAM INJECTOR.

3. TB MEANS THERMOCOUPLE BREAK

4. INTERNAL PLC INTERLOCK.

5. ~~DELETED~~

6. ALARM DISABLED IN DCS.

REV

DATE

DESCRIPTION

DRAWN

CHKD

APPD

REFERENCE DRAWING

5

19 Oct. 2016

REVISED AS PER MOC NO. SPCo-P-2722

PTB

SKS

KMN

FOR NCP LEGEND AND SYMBOLS SEE DRAWINGS.

4

31 Aug. 2016

REVISED AS PER MOC SPCo-P-4509

CH

PD

KMN

NCP-00-P1-EF-100 THRU NCP-00-P1-EF-171

3

17 Jul. 2016

AS PER DSR SPCo-2015-00361

MRH

JRB

KMN

2

09 Aug. 2015

REVISED AS PER MOC NO. SPCo-P-3887

PTB

MH

KMN

1

20 Aug. 2014

REVISED AS PER MOC SPCo-P-2281.

RAC

S.K

KMN

0

15 Apr. 2011

AS BUILT

HMY

YK/SS

CONFIDENTIAL INFORMATION - REPRODUCTION AND USE PROHIBITED EXCEPT IN ACCORDANCE WITH COMPANY'S WRITTEN PERMISSION. THIS TECHNOLOGY IS SUBJECT TO U.S. EXPORT CONTROL LAWS. DIVERSION CONTRARY TO U.S. LAW PROHIBITED.

DAELIM

MANAGING CONTRACTOR

WorleyParsons

Worley & Parsons

AS BUILT

NCP PROJECT

SCALE: NONE

PROJECT NO: 156352

CONTRACT NO. / WORK ORDER NO: NCP-SE-001

CONTRACTOR

CONTRACTOR APPROVAL

NCP APPROVAL

SCIP/JCP REVISION

INITIAL

DATE

DLB

19 Jan. 2009

JWK

20 Feb. 2009

OH

20 Feb. 2009

TITLE

PIPING AND INSTRUMENT DIAGRAM

EXTRUDER BARREL SYSTEM

DWG. NO: NCP-43-P1-EF-807

REV: 5

THIS DOCUMENT CONTAINS CONFIDENTIAL AND PROPRIETARY INFORMATION OF CHEVRON PHILLIPS CHEMICAL COMPANY LP. THE DOCUMENT AND THE INFORMATION ARE NOT TO BE REPRODUCED IN ANY MANNER OR SUBMITTED TO OUTSIDE PARTIES FOR EXAMINATION OR USED DIRECTLY OR INDIRECTLY FOR PURPOSES OTHER THAN THOSE FOR WHICH THEY WERE FURNISHED, EXCEPT WITH THE WRITTEN PERMISSION OF CHEVRON PHILLIPS CHEMICAL COMPANY LP.

FILE NAME: NCP-43-P1-EF-807

NCP-43-P1-EF-807

A1 8415284